


LAYOUT

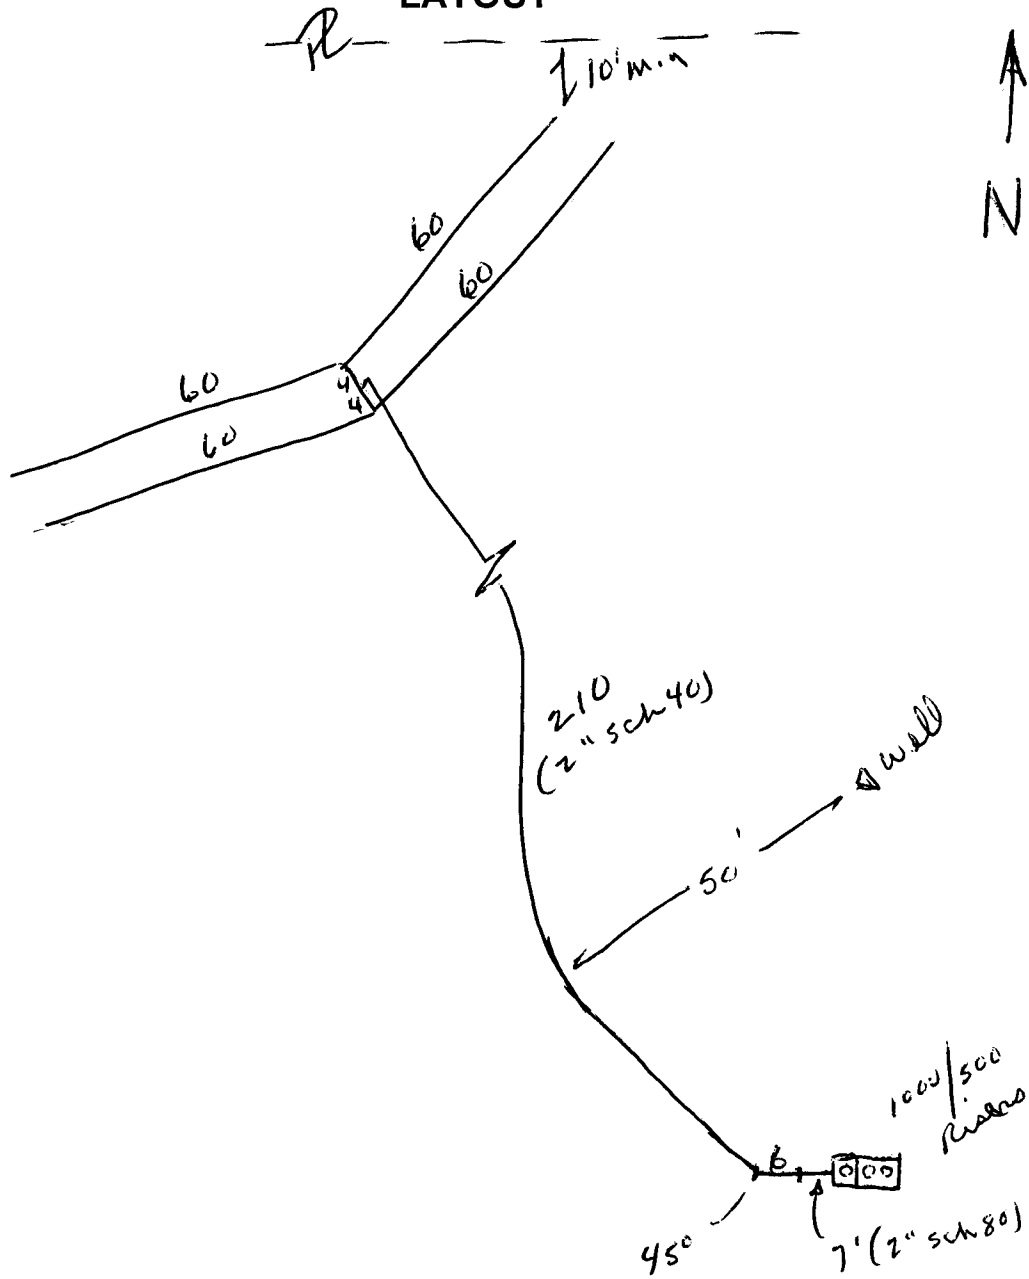

GPS Location: North

Deg. ,

West

Deg. ,

Water source developed at time of inspection? YES NO Distribution YES NO

Disapproved/Date _____ Comments _____

Approved/Date 9/1/10 Comments 240LF x 3 = 720ft²

Pump - Myers ME 40
Tested - 6' head

Inspectors Signature Glen Gray Name of Installer/Phone Patrick Michel
755-4087