

NEW

SEPTIC TANK PERMIT
for
LINCOLN COUNTYPermit Sent


Phone 295-5498

Date 11-1-79

Property Owner Edward Bailey Address Rt 2, Troy (Angel Island)Lot, Block Number, or legal description of Property Lot 33, Block 1 - Angel IslandTo be built by: M. Warrington Square feet absorption area. 950Septic Tank Size 1000 gal # of bedrooms 3 Water Supply CommunityDescription of Absorption Area: Construct a seepage bed as per lot layout and attached sheet. Drainpipe in bed should be at 0% slope.

Sketch; Must include property lines, buildings, and proposed septic tank-drainfield layout. Sketch must show distance from absorption area to wells, springs, streams, or lakes. Indicate depth of water table. Indicate slope.


DITCH DIAGRAM

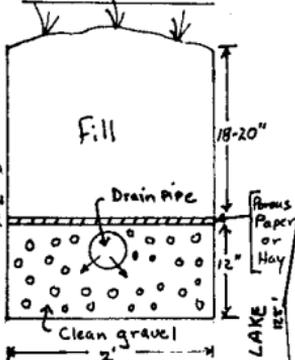

SOIL: Sandy Loam

SLOPE: 1%

LOT LAYOUT

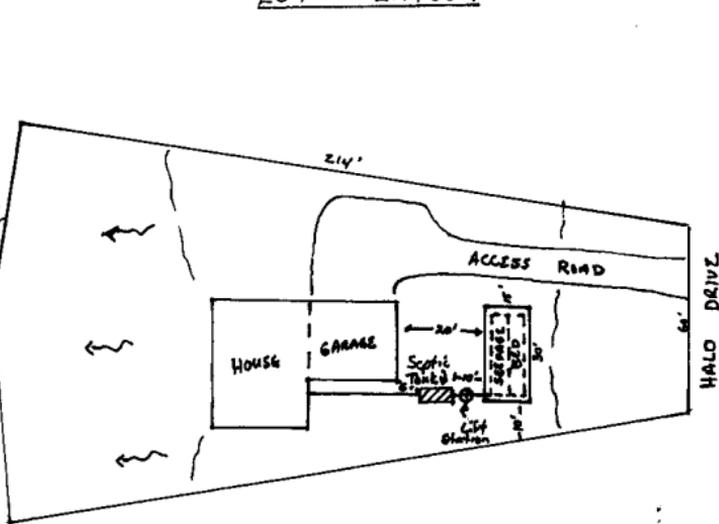Issued by John W. Peterson, R.S. Inspected by _____Date 11-1-79