

PERMIT #: 98-132

MISSOULA CITY-COUNTY HEALTH DEPARTMENT  
301 W. ALDER (406)523-4755  
SEWER PERMIT AND APPLICATION

OWNER NAME: Dick Seale PHONE: (318)869-4118  
OWNER ADDRESS: 89 Doubly Square Loisiana ZIP: \_\_\_\_\_  
CERTIFIED INSTALLER: John Miller  
LEGAL DESCRIPTION: 1/4 SE 1/4 T 16 R 14 S 5  
ADDRESS OF SITE: End of Elk Horn Rd  
CERTIFICATE OF SURVEY #: \_\_\_\_\_ SUBDIVISION: Double Arrow Phase V  
LOT: 20 BLOCK: \_\_\_\_\_ TRACT: \_\_\_\_\_ SIZE OF PARCEL: \_\_\_\_\_  
GENERAL AREA NAME: Sagey Lake

SEPARATION ADEQUATE FOR:  
(INFO SUPPLIED BY APPLICANT) (CHECK ALL)

|                                | YES                                 | NO                       |
|--------------------------------|-------------------------------------|--------------------------|
| WELLS >100'                    | <input checked="" type="checkbox"/> | <input type="checkbox"/> |
| WATER LINES >10'               | <input checked="" type="checkbox"/> | <input type="checkbox"/> |
| FLOODPLAIN >100'               | <input checked="" type="checkbox"/> | <input type="checkbox"/> |
| SURFACE WATER >100'            | <input checked="" type="checkbox"/> | <input type="checkbox"/> |
| HGW >6', >5', >3'              | <input checked="" type="checkbox"/> | <input type="checkbox"/> |
| BEDROCK >6'                    | <input checked="" type="checkbox"/> | <input type="checkbox"/> |
| SLOPE >25% & <50% = 2'x (%-25) | <input checked="" type="checkbox"/> | <input type="checkbox"/> |
| PROPERTY LINES, BLDGS >10'     | <input checked="" type="checkbox"/> | <input type="checkbox"/> |

Special Conditions and Other Information

|   |     |  |
|---|-----|--|
| * SANITARY RESTRICTIONS ON LOT?           | YES | NO <input checked="" type="checkbox"/> |
| * ANY EXISTING SEPTIC SYSTEMS?            | YES | NO <input checked="" type="checkbox"/> |
| UPGRADE REQUIRED?                         | YES | NO <input checked="" type="checkbox"/> |
| * INSIDE OR NEAR FLOODPLAIN:              | YES | NO <input checked="" type="checkbox"/> |
| * PUBLIC SEWER GREATER THAN 200 FEET:     | YES | NO <input checked="" type="checkbox"/> |
| * PROPERTY LOCATED IN MWTPSA?             | YES | NO <input checked="" type="checkbox"/> |
| FOR NEW OR INCREASED USE                  |     |  |
| ____ SUBDIVISION PLAT LANGUAGE EXISTS     |     |  |
| ____ DEED RESTRICTION FILED               |     |  |
| * PROPERTY LOCATED IN S.T.E.P. AREA?      | YES | NO <input checked="" type="checkbox"/> |
| ____ CITY S.T.E.P. TANK & PERMIT REQUIRED |     |  |

SOIL TYPE: Silty Clay  
WATER SUPPLY: well

TYPE OF SYSTEM TO BE INSTALLED: X NEW: \_\_\_\_\_ REPLACEMENT  
SYSTEM SIZING: X RESIDENTIAL: #OF BEDROOMS: 2 GAL/DAY: 300  
COMMERCIAL: USE \_\_\_\_\_ GAL/DAY: \_\_\_\_\_

APPLICATION RATE (Gal/day or sq. ft./bedroom): 10  
FROM: PLAT APPROVAL \_\_\_\_\_; SITE EVALUATION: X; ENGINEER: \_\_\_\_\_  
SYSTEM SIZE & DESCRIPTION: 1000 Gallon (X concrete, \_\_\_\_\_ STEP, \_\_\_\_\_ other) septic tank with  
150 lineal feet of 24 inch trench drainfield as per site plan attached. Install an 8 inch capped riser from tank

to surface. STEPS tank requires manway and lid to be inspected by the City.  
SPECIAL CONDITIONS: \_\_\_\_\_

As purchaser of this permit, I agree to comply with all requirements for installation as described in Missoula City-County Code Regulation #1, State Water Quality Bureau Regulations and special conditions described above. This document does not release me from complying with any other State, Federal or Local regulations including but not limited to zoning, building and floodplain regulations.

This permit is valid for twelve (12) months from date of purchase. Sewage disposal systems must be completed within this time and inspected by the Department prior to covering the system. A copy of this permit is to be on site at all times during construction and inspection of the system. Please use the permit number in the upper right hand corner for reference when you call for a final inspection.

Permit purchaser: [Signature] Date: 5-12-98  
Health Authority: [Signature] Date: 5/12/98

## SEWER PERMIT CHECKLIST

### ALL PERMITS:

\*\*\*\*\*

SITE PLAN ATTACHED TO PERMIT

#### HOOK-UP TO MUNICIPAL SEWER IS REQUIRED IF: (CHECK ONE)

<200' TO PROPERTY LINE IF IN CITY LIMITS  CALLED AND REFERRED TO CITY ENGINEERS OFFICE  
 <200' TO BUILDING IF OUTSIDE CITY LIMITS  DATE \_\_\_\_\_  
 NOT WITHIN 200 FEET OF MUNICIPAL SEWER  \_\_\_\_\_ PERSON CONTACTED

#### SPECIAL MANAGEMENT AREAS: (see section XV of Health Code)

LINDA VISTA - Connect to public sewer.  
 MWTPSA - IF YES, IS DEED RESTRICTION FILED? YES \_\_\_\_\_  
OR SUBDIVISION PLAT LANGUAGE EXISTS: YES \_\_\_\_\_  
 RATTLESNAKE - ONE SYSTEM PER LOT - 25' VERTICAL & 100' HORIZONTAL SEPARATION FROM VALLEY  
 ROMAN CREEK/TOUCHETTE LANE (W 1/2 SEC 27, S 28, E 1/2 S 29, T 15N, R 21W)  
 (NORTH OF I-90 AND SOUTH OF FRENCHTOWN CANAL) - CONDITIONS MET \_\_\_\_\_

#### TYPE OF PARCEL: (CHECK ONE)

SUBDIVISION FILED PRIOR TO 5/27/61 REQUIRE A SITE EVALUATION. S.E. IN FILE \_\_\_\_\_ (YES OR NO)  
 SUBDIVISION FILED AFTER 5/27/61 WITHOUT LIFTING REQUIRE SUBDIVISION REVIEW. S.E. IN FILE \_\_\_\_\_  
 SUBDIVISION FILED AFTER 5/27/61 WITH RESTRICTIONS LIFTED AND RECORDED  
 COS W/LIFTING ON FILE/RECORDED  
 COS WITH >20 ACRE EXEMPTION (REQUIRES SITE EVALUATION) SITE EVALUATION ON FILE \_\_\_\_\_ (YES OR NO)  
 COS WITHOUT LIFTING ON FILE (IS USUALLY AN EXEMPTION FOR WHICH NO PERMIT CAN BE ISSUED i.e. AG., CEMETERY, etc.)  
 TRACTLAND REQUIRES A SITE EVALUATION. (>5 (BEFORE 1973), >10 (BEFORE 1975), >20 ACRES)

### NEW PERMITS:

\*\*\*\*\*

#### PLANNING/ZONING PERMIT REQUIRED (CHECK ONE)

INSIDE BUILDING INSPECTOR ZONE - BUILDING PERMIT APPLICATION REQUIRED  
 IN ZONED AREA OR IN OR NEAR FLOODPLAIN - COMPLIANCE PERMIT REQUIRED.  
 OUTSIDE BUILDING INSPECTOR ZONE - NOT IN ZONED AREA OR IN FLOODPLAIN.

#### SIZE OF PARCEL OR PARCELS: \_\_\_\_\_

IF <1/2 ACRE, OWNERSHIPS OF CONTIGUOUS LOTS (prior to May 19, 1986)  
DETERMINED FROM ASSESSORS OFFICE. (SEE SECTION V(D)(2))

### REPLACEMENT SYSTEMS:

\*\*\*\*\*


#### HIGH GROUND WATER OR BEDROCK:(CHECK ONE)

HIGH GROUNDWATER OR BEDROCK AREA - DRAINFIELD, ADSORBTION BED, OR SHALLOW SEEPAGE PIT REQUIRED  
 NOT A HIGH GROUND WATER OR BEDROCK AREA

#### SITE VISIT:(CHECK ONE)

SITE VISIT REQUIRED TO VERIFY ROOM FOR:1) DRAINFIELD, ABSORBTION BED OR SEEPAGE PITS 2) GROUNDWATER  
3) WELLS 4) ETC.  
 SITE VISIT NOT NECESSARY TO VERIFY SOILS, SPACE FOR ADSORBTION AREA, DISTANCE TO WELLS, OR  
GROUNDWATER.

Dick Seales  
Phase 3  
Double Arrow  
Seeley Lake MA  
59868

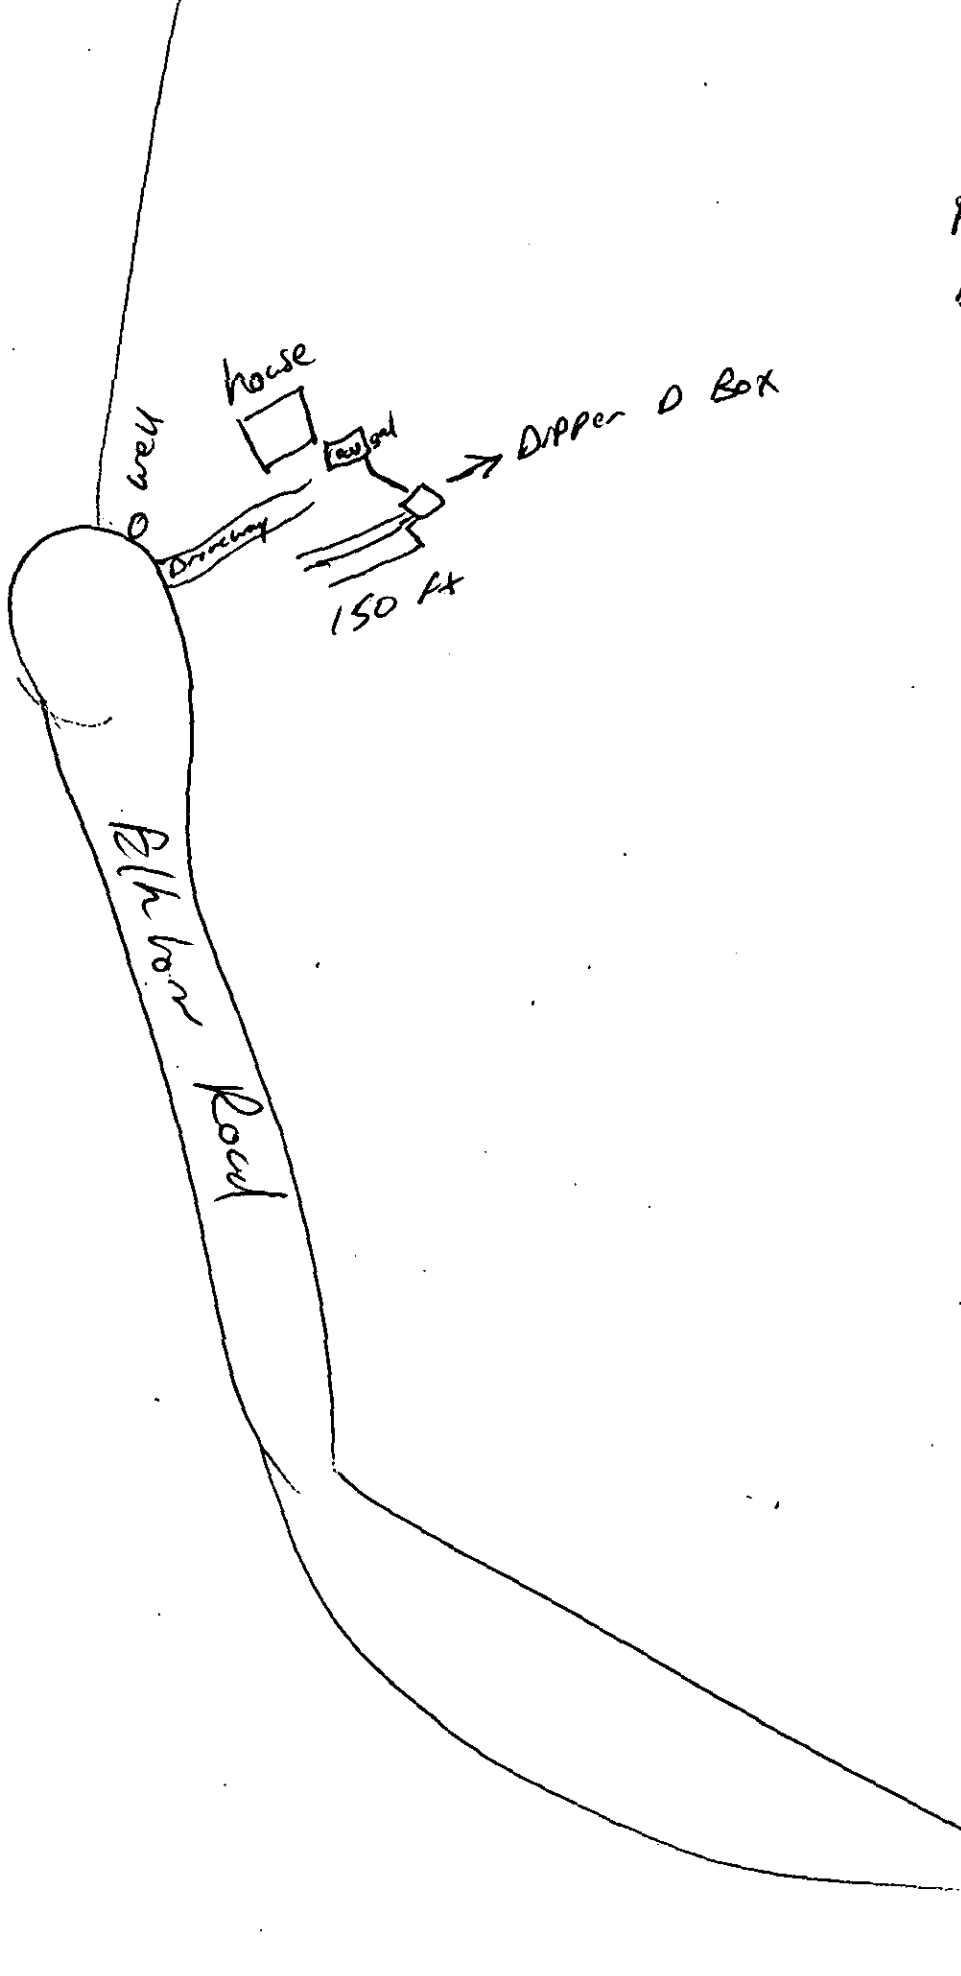

Lot  
20  
Elkhorn Road