


CERTIFICATE OF REGISTERED LAND SURVEYOR

I, HERBERT C. THOMAS, III, AM A REGISTERED PROFESSIONAL LAND SURVEYOR IN THE STATE OF ALASKA. I HAVE SURVEYED THE ABOVE DESCRIBED PROPERTY AND THE BOUNDARIES THEREOF, AND I CERTIFY THAT THE SAME ARE CORRECTLY SHOWN THEREON ACCORDING TO THE BEST OF MY KNOWLEDGE AND BELIEF.

DATE: _____ REGISTERED LAND SURVEYOR

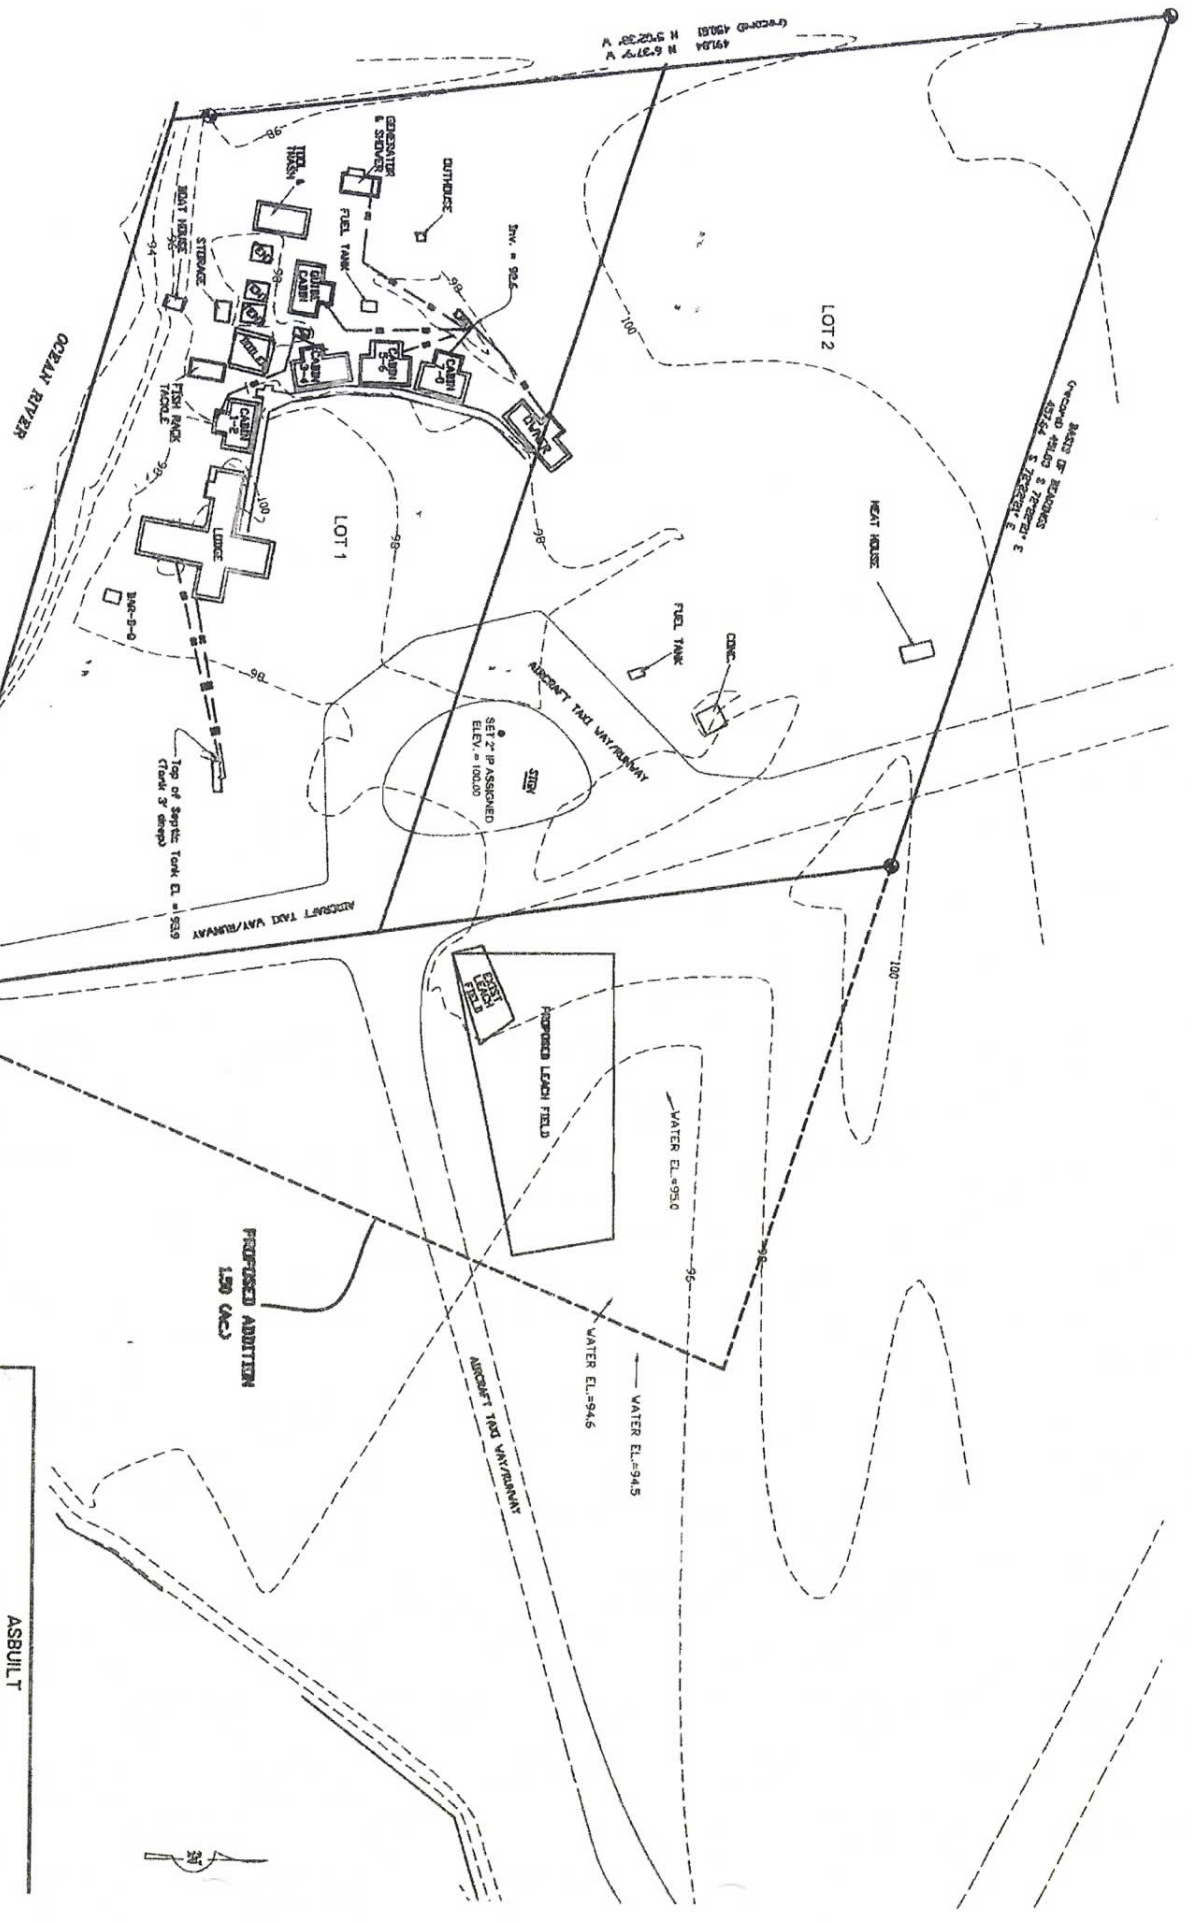

ASBULL T
WILDMAN LODGE
 LOTS 1 & 2
 A.S.L.S. 87-131A
 WITHIN S.16, T.43S, R.67W, S.M.

Coastal Surveyors, Inc.

PROFESSIONAL LAND SURVEYORS
 BOX 161 NANKNER AK 99633 (907) 246-4408

CAD OPERATOR	DATE: SEPT. 20, 2003	PROJ. # 2003
CHECKED BY: jpm	SCALE: 1" = 50'	SHEET 1 OF 1