

Permit No. 92-326


MISSOULA CITY-COUNTY HEALTH DEPARTMENT
301 W. Alder 721-5700

INDIVIDUAL SEWER SYSTEM INSPECTION REPORT

Name of Owner Sheldon Vernon
Legal Address/Location NE 1/4 T19 R10 S21 / Corridor Hwy 83 Summit
Certified Installer Matthew Bros Const.

Type System: New Replacement X
Septic Tank: Capacity: 1000 gal. X Other gal., Material: Concrete X Other , Depth to top: 1 ft. in.
Drainfield: Total length 240 ft., # of laterals 7, Trench Depth 18-24 in. to bottom
Seepage Pit: Height ft., Depth to Top ft. in.
Distance of Installation From: Property Lines: Wells: 100+ Surface Water: 100+ Other

Soil Type Sandy Loam

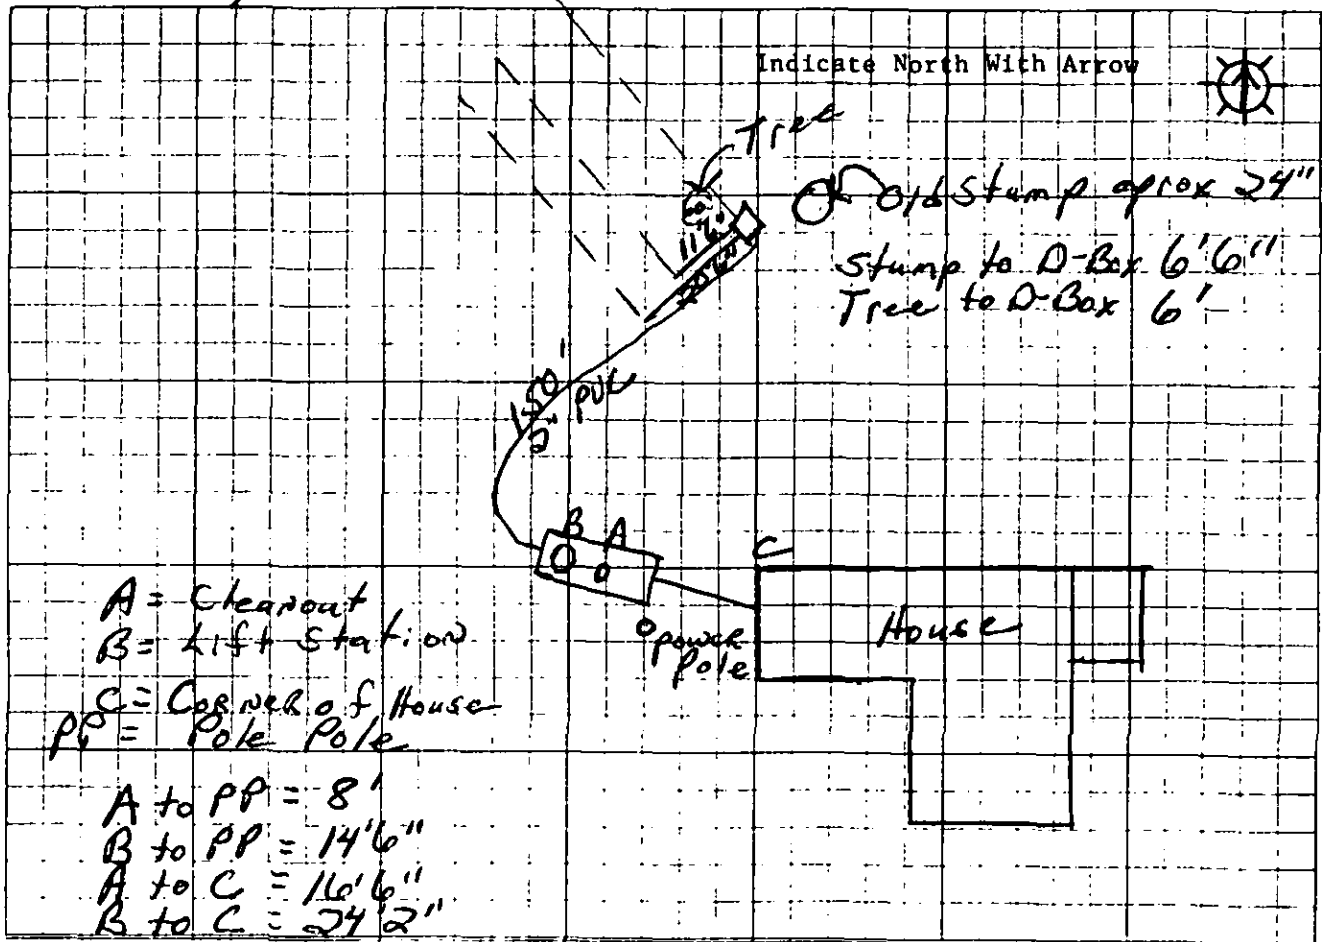

Installation Inspected: Approved X

Disapproved

Matthew
Sanitarian

7/28/92
Date

Corrections Necessary:

Inspection Witnessed By:

Date

Deficiencies Corrected: yes no

Sanitarian

Date

SEWER PERMIT AND APPLICATION

FEE \$ 75.00

Owner/Applicants Name Sheldon Vernon Phone# _____

Owner/Applicants Address Hwy 83 Summit

Certified Installer Matthew Bros

Location of Installation: _____ 1/4 NW 1/4 T 19 R 16 Section 21

Address of Site Hwy 83

Certificate of Survey # _____ HD # _____

Subdivision _____

Lot _____ Block _____

Tractland _____

General area name Cordon

Size of Lot or Parcel 10+ acres

Any existing structure or sewage disposal facilities: Yes X No _____

If Yes, Explain: failed system

Residential - Number of Bedrooms 2 Commercial _____ gal/day 300

Water supply: Private X Public _____ Multi-family _____

Soil Type Sandy loam

Depth to groundwater 10'

Type of system to be installed: New _____ Replacement X

System size: From Plat approval _____ From site ^{VISIT} evaluation # _____

Application rate _____ Gal./square Ft/day

Square feet per bedroom 240

Engineered _____

Description of System to be installed 1000 GAL TANK AND
240 linear feet of drainfield

Special Conditions Pump station required with
dist. box

As purchaser of this permit, I agree to install an individual sewer system which meets all requirements as specified in the Missoula County rules and regulations for subsurface sewage disposal systems.

Permit Pruchaser [Signature] Date: 7/28/92

Health Authority [Signature] Date: 7/28/92

This permit is valid for 12 months. Construction of the sewage disposal system must commence during this time or the permit is no longer valid. A final inspection by the Department is required prior to covering the installed system. Applicant's copy of the permit must be on-site at the time of inspection. Please use the permit number in the upper right hand corner for reference when you call for a final inspection.