

PERMIT APPROVAL SPECIFICATIONS
Sanders County Environmental Health Department
 1111 Main St. Thompson Falls, MT, 59873 * 406.827.6961

Owner information:

Jason Van Voast	9	26N	33W
_____	S	T	R
2500 Irvine Flats	7/01/05		
_____	Date Submitted		
Polson, MT 59860	7/11/05		
_____	Date Approved		
City	7/11/06		
_____	Expiration Date		
06-11	Permit Number		
_____	Permit Number		

Permit Specifications:

This permit is approved with the following specifications:

1000 _____ size of septic tank

125 _____ lineal feet of drainfield

(250 square feet of drainfield)

List design specifications:

Install a Standard Absorption Trench System. Remember to keep the trenches no deeper than 24 inches. Install laterals in 2 trenches, each trench 62.5 feet in length and 2 feet wide. Please follow all county wastewater regulations & the state regulations as outlined in Circular DEQ 4 2002 edition. Install the system exactly as per approved lot layout. Pre-notification is mandatory before backfilling system.



*8/15/05
 Jim Niet called
 Infiltrators ok
 2 laterals @ 47 ft.
 BW*

Barbara Woodbury RS

 Sanders County Sanitarian

**AS-BUILT SKETCH
AND
STATEMENT OF ACCURACY OF INSTALLATION**

Land owner's name JASON VAN VOAST

Permit number 06-11

I, Jim Hilt, as the licensed installer or landowner for the following system have constructed or altered the septic system on the parcel referenced by the permit number above.

I do hereby declare that the EXACT specifications of the approved permit have been followed. Accompanying this statement is a copy of the county approved lot layout and my as-built sketch. My as-built sketch is included on another sheet of paper. I **understand that it is my responsibility to submit the above within 10 days of the completion of the system.**

Installer's Signature Jim Hilt

Installer's License Number LI 11102

Completion Date of System 8-19-05

.....
Checklist of as-built sketch:

- North Arrow
- Triangular measurements from two corners of house to tank access lid
- Measurement of pipe from tank to D-box or manifold
- All parcel boundaries**
- Distance between the system and at least two parcel boundaries


Additional information needed (fill the blanks in with quantitative data):

51.6 length of drainfield laterals Asphalt
2 number of drainfield laterals
1000 volume of septic tank


PROPERTY LINE 193'7"



200'

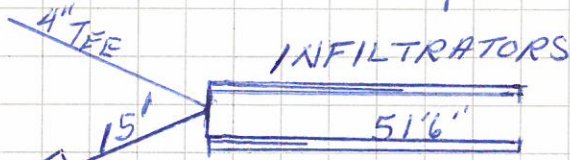

25% Reduction off
 of 62.5 = 46.875
 + installed 51.6'
 172'

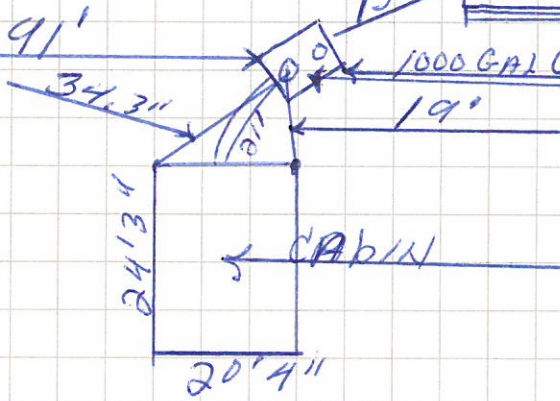

PROPERTY LINE


153'7" PROPERTY LINE

AS Built

APPROVED
 8/31/07
 DATE INITIAL

LEGEND

- ▲ SOIL PROFILE
- PERC SITE
- 2 LINE Dist. Box
- ⊗ CLEAN OUT
- ⊞ 1,000 gal Conc. SEPTIC TANK
- ⊙ PROPOSED WELL SITE
- ⌒ " " POWER Pedestal
- - - " " BURIED POWER LINE

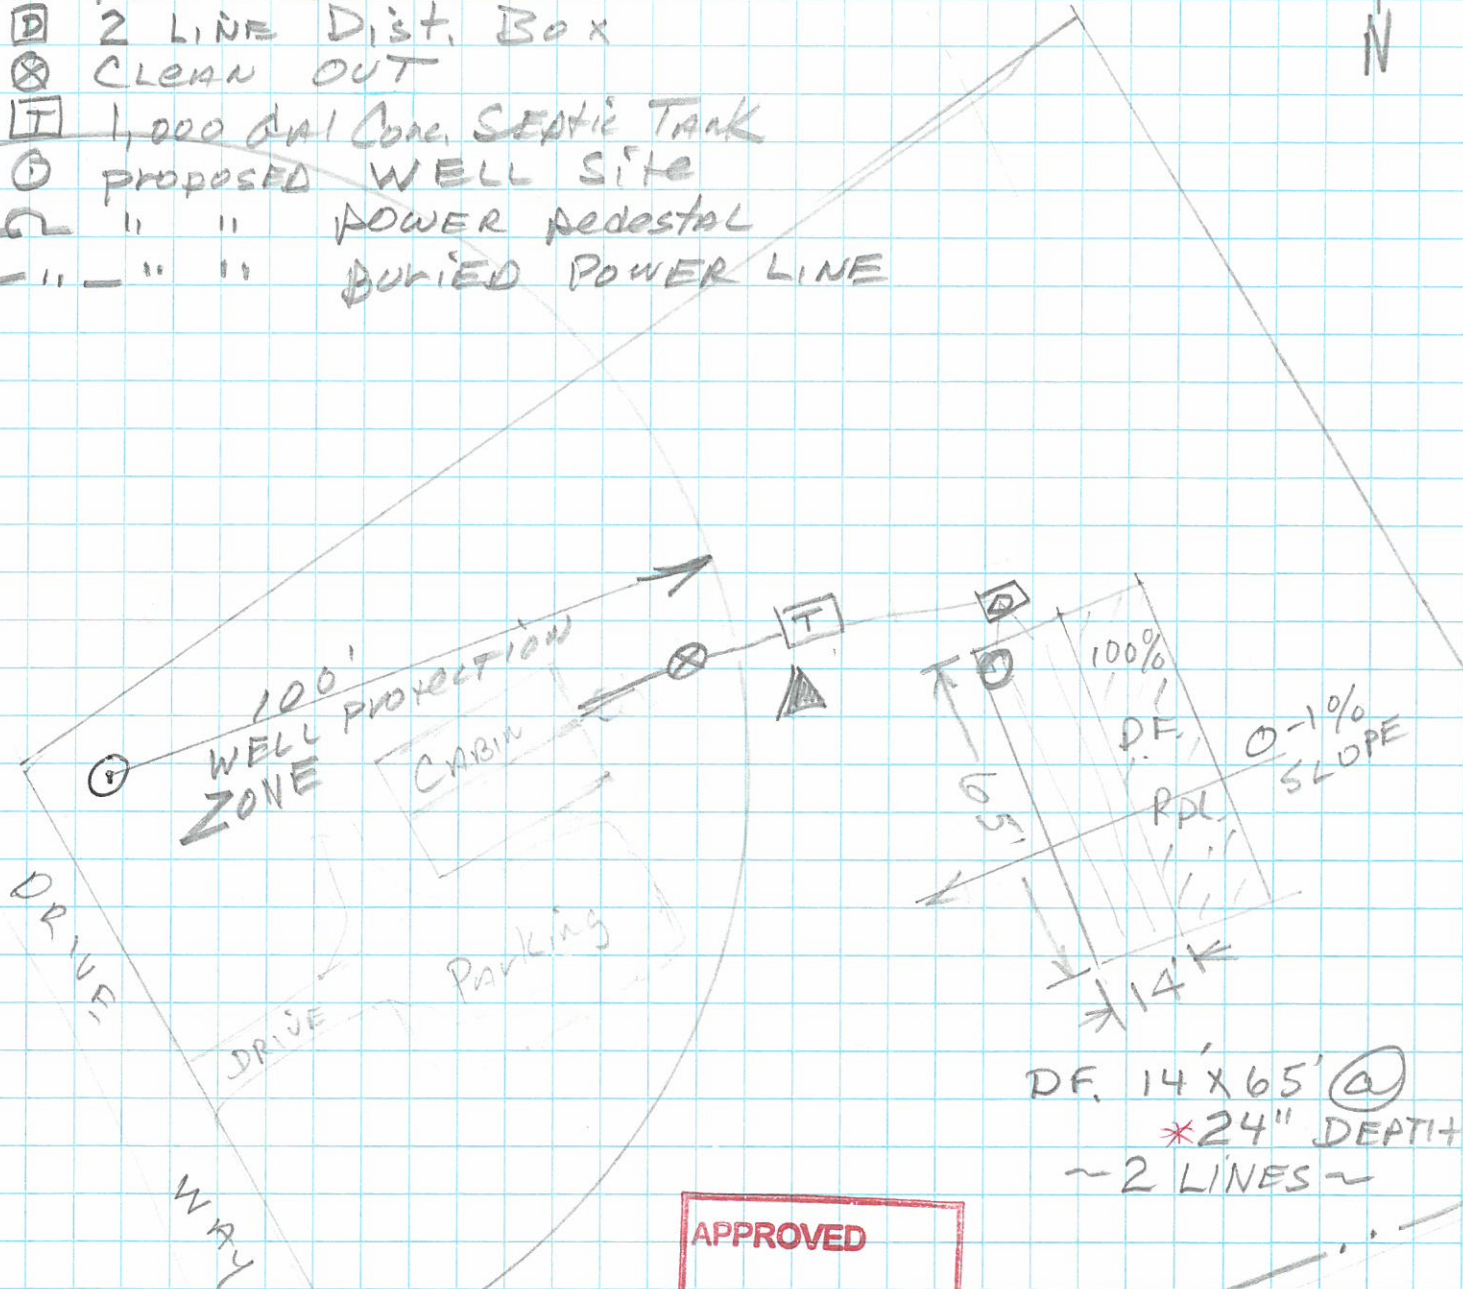

APPROVED
 DATE 2/11/05 INITIAL BW

SCALE 1" = 30'

SITH, BABB
 L&E. NX 20
 6/24/05

MONTANA DEPARTMENT OF ENVIRONMENTAL QUALITY
PERCOLATION TEST FORM

Owner Name JASON VAN VOAST

Project Name 1 ROOM CABIN

Lot of Tract Number _____ Test Number 1

Diameter of Test Hole 6" Depth of Test Hole 24"

Date and Time Soak Period Began 5:42A 5/31/05 Ended 6:22A 5/31/05

Date Test Began 5/31/05

Distance of the reference point above the bottom of the hole 24 3/4" (BOARD)

Test Results

Start Time of Day	End Time of Day	Time Interval (Minutes)	Initial Distance Below Reference Point	Final Distance Below Reference Point	Drop in Water Level (inches)	Percolation Rate (minutes/inch)
6:22	6:32	10	18 3/4"	21 3/4"	3	3.3
6:32	6:44	12	18 3/4"	22"	3 1/4"	3.6
6:44	6:54	10	18 3/4"	21 1/4"	2 1/2	4.0
6:54	7:04	10	18 3/4"	21 1/8"	2 3/8"	4.2
7:04	7:14	10	18 3/4"	21"	2 1/4"	4.4
7:14	7:24	10	18 3/4"	21"	2 1/4"	4.4

I certify that this percolation test was done in accordance with DEQ-4, Appendix A.

4:4 AM

STEVEN H. BABB
Name (printed)

[Signature]
Signature

6/7/05
Date

LSF NX 20
Company

NITRATE ANALYSIS EQUATION

Project No. Van Voast
 Date 6/24/05
 By S.H. BABI

Tract or Lot No. 10

VARIABLES

K = 50,134 ft/day
 i = 0.26 ft/ft
 d = 16.4 ft.

 w = 65 ft.

 l = 100 ft.
 N_g = 1.07 ppm
 N_r = 1.0 ppm
 N_e = 50 ppm

 f = 1
 Q_f = 26.7 ft³/day
 p = .01 ft/day**
 I = 0.20

Hydraulic conductivity 250: 1 = 2500 x 1500 = 3,750,000 ÷ 748 = 501,337 ÷ 10 = 50,134
 Hydraulic gradient
 Mixing zone thickness (standard is 16.4 ft; site (source) specific can be less)
 Width of primary drainfield (measured perpendicular to ground-water flow direction)
 Length of mixing zone
 Nitrate (as nitrogen) in background groundwater
 Nitrate (as nitrogen) in recharge water
 Nitrate (as nitrogen) in drainfield effluent (50 ppm for standard drainfield; 24 ppm for level II treatment)
 No. of single family homes using treatment system
 Effluent discharge (default is 26.7* for single family home)
 Precipitation (based on local average)
 Percent of precipitation that reaches groundwater (0.10 for slopes >15%)

EQUATIONS

W = (0.175)(l) + w = 82.5 ft Mixing zone width at downgradient end of mixing zone

 A_m = (W)(d) = 1,066 ft² Mixing zone area
 A_s = (W)(l) = 6500 ft² Mixing zone surface area
 Q_g = (K)(i)(A_m) = 1,389,513 ft³/day Groundwater volumetric rate
 Q_r = (A_s)(p)(I) = 13 ft³/day Precipitation volumetric rate
 Q_e = (f)(Q_f) = 26.7 ft³/day Effluent volumetric rate 80
75

 Q_t = Q_g + Q_r + Q_e = 1,389,552 ft³/day Total water volumetric rate

 N_t = $\frac{(N_g)(Q_g) + (N_r)(Q_r) + (N_e)(Q_e)}{Q_t}$ = $\frac{97,265 + 13 + 1335}{1,389,513}$ = 98,614 Nitrate (as nitrogen) concentration at end of mixing zone.

 = 0.07 ppm (with standard drainfield)
 or
 = _____ ppm (with level II treatment)

NOTES:

- * 26.7 ft³/day is equal to 200 gallons per day.
- ** Multiply precipitation rate in inches/year by conversion factor of 0.00023 to get precipitation in ft/day.

Looks OK

MONTANA DEPARTMENT OF ENVIRONMENTAL QUALITY

PHOSPHOROUS BREAKTHROUGH ANALYSIS

SITE NAME: VAN VOAST
COUNTY: SANDERS
LOT #: 10
NOTES: _____

<u>VARIABLES</u>	<u>DESCRIPTION</u>	<u>VALUE</u>	<u>UNITS</u>
Lg	Length of Primary Drainfield as Measured Perpendicular to Ground Water Flow	<u>65</u>	ft
L	Length of Primary Drainfield's Long Axis	<u>65</u>	ft
W	Width of Primary Drainfield's Short Axis	<u>14</u>	ft
B	Depth to Ground Water from Bottom of Drainfield Laterals*	<u>6'</u>	ft
D	Distance from Drainfield to Surface Water	<u>700'</u>	ft
T	Phosphorous Mixing Depth in Ground Water (0.5 ft for coarse soils; 1.0 ft for fine soils)**	<u>.5</u>	ft
Ne			
Sw	Soil Weight (usually constant)	100.0	lb/ft ³
Pa	Phosphorous Adsorption Capacity of Soil (usually constant)	200.0	ppm
#	Number of Single Family Homes on the Drainfield	<u>1</u>	

CONSTANTS

PI	Phosphorous Load per Single Family Home (constant)	<u>6.44</u>	lbs/yr
X	Conversion Factor for ppm to percentage	<u>1.0E+06</u>	

EQUATIONS

Pt	Total Phosphorous Load = (PI)(#)	<u>6.44</u>	lbs/yr
W1	Soil Weight under Drainfield = (L)(W)(B)(Sw)	<u>546,000</u>	lbs
W2	Soil Weight from Drainfield to Surface Water = (Lg)(D)(T)(Sw)	<u>2,275,000</u>	lbs
P	Total Phosphorous Adsorption by Soils = (W1 + W2)((Pa)/(X))	<u>564.2</u>	lbs

SOLUTION

BT Breakthrough Time to Surface Water = P / Pt 87.6 years

BY: S. H. BABB
DATE: 6/24/05

Looks ok Bob

NOTES: * Depth to shallow water is typically based on depth to water in a test pit or bottom of a dry test pit minus two feet to account for burial depth of standard drainfield laterals.
 ** Material type is usually based on test pit. A soil that contains more than 35% silt and clay sized particles is considered fine grained.

Revised checklist for non-deg review

Rev 8-10-99

1. Well log

- 250 A. Q=pumping rate (N=Q)
- .1 B. s=drawdown (SWL-PWL) (N=s)
- 1500 C. Confined (2000) vs. Unconfined (1500) (N=factor)
- 10 D. Aquifer thickness (N=B)

2. Review site eval-soils

- 8' A. Depth of soil profile (P=B)
- .5 B. Soil type (1.0 fine; 0.5 coarse) (P=T)

3. Lot layout

- 65' A. Length of drainfield (Perpendicular to gw flow) (N=w) (P=Lg, L)
- 14" B. Width of drainfield (P=W)
- 5 C. Configuration of drainfield
- 700' D. Drainfield to surface water (P=D)

4. Hydraulic gradient

- ✓ A. How was it calculated
- ✓ B. Topo map, if required
- 20 C. Scale of topo map
- 026 D. Hydraulic gradient (conservative 0.001) (N=i)

5. Misc

- .07 A. Background nitrates (N=Ng)
- 100 B. Mixing zone (N=L)
- 101 C. Precip from chart (feet/day) (N=P)
- 1 D. Number of families on system (N=#1) (P=#1)

**Montana Bureau of Mines and Geology
Ground-Water Information Center Site Report
CABINET GORGE CAMPGROUND**

Plot this site on a topographic map

Location Information

GWIC Id: 80049	Source of Data: LOG
Location (TRS): 26N 33W 09 ACAB	Latitude (dd): 48.0281
County (MT): SANDERS	Longitude (dd): -115.8489
DNRC Water Right: W130324-00	Geomethod: MAP
PWS Id: 02058002	Datum: NAD27
Block:	Altitude (feet): 2290.00
Lot:	Certificate of Survey:
Addition:	Type of Site: WELL

Well Construction and Performance Data

Total Depth (ft): 315.00	How Drilled: ROTARY
Static Water Level (ft): 50.00	Driller's Name: DEMMING
Pumping Water Level (ft): 50.00	Driller License:
Yield (gpm): 250.00	Completion Date (m/d/y): 1/1/1950
Test Type:	Special Conditions:
Test Duration: 16.00	Is Well Flowing?:
Drill Stem Setting (ft):	Shut-In Pressure:
Recovery Water Level (ft):	Geology/Aquifer: Not Reported
Recovery Time (hrs):	Well/Water Use: PUBLIC WATER SUPPLY
Well Notes:	

Hole Diameter Information

No Hole Diameter Records currently in GWIC.

Casing Information¹

From	To	Dia	Wall Thickness	Pressure Rating	Joint	Type
0.0	0.0	6.0				

Annular Seal Information

No Seal Records currently in GWIC.

Completion Information¹


No Completion Records currently in GWIC.

Lithology Information

From	To	Description
0.0	2.0	TOP SOIL
2.0	20.0	COARSE GRAVEL
20.0	310.0	FINE GRAY SILT
310.0	315.0	COARSE GRAVEL

¹ - All diameters reported are **inside** diameter of the casing.

These data represent the contents of the GWIC databases at the Montana Bureau of Mines and Geology at the time and date of the retrieval. The information is considered unpublished and is subject to correction and review on a daily basis. The Bureau warrants the accurate transmission of the data to the original end user. Retransmission of the data to other users is discouraged and the Bureau claims no responsibility if the material is retransmitted. Note: non-reported casing, completion, and lithologic records may exist in paper files at GWIC.

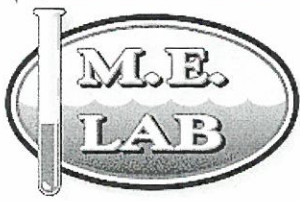

ANALYTICAL REPORT

Montana Environmental Laboratory LLC

Van Voast Row 1

Prepared for:

Steven Babb
P. O. Box 1551
Noxon, MT 59853

ORDER#: G0504676

Location: Van Voast

Matrix: DRINKING WATER

Date Collected: 06/09/2005

PWS ID:

Date Received: 06/10/2005


Lab ID: 0504676-01

Test Parameters

<u>Parameter</u>	<u>Result</u>	<u>Units</u>	<u>MDL</u>	<u>MCL</u>	<u>Method</u>	<u>Date Analyzed</u>	<u>Analyst</u>
Nitrate	0.07	mg/L	0.01	10	353.2	06/14/2005	JWH

MCL = Maximum Contaminant Limit ND = Not Detected
MDL = Minimum Detection Limit NR = Not Regulated

MEL REVIEW: *Jmc*

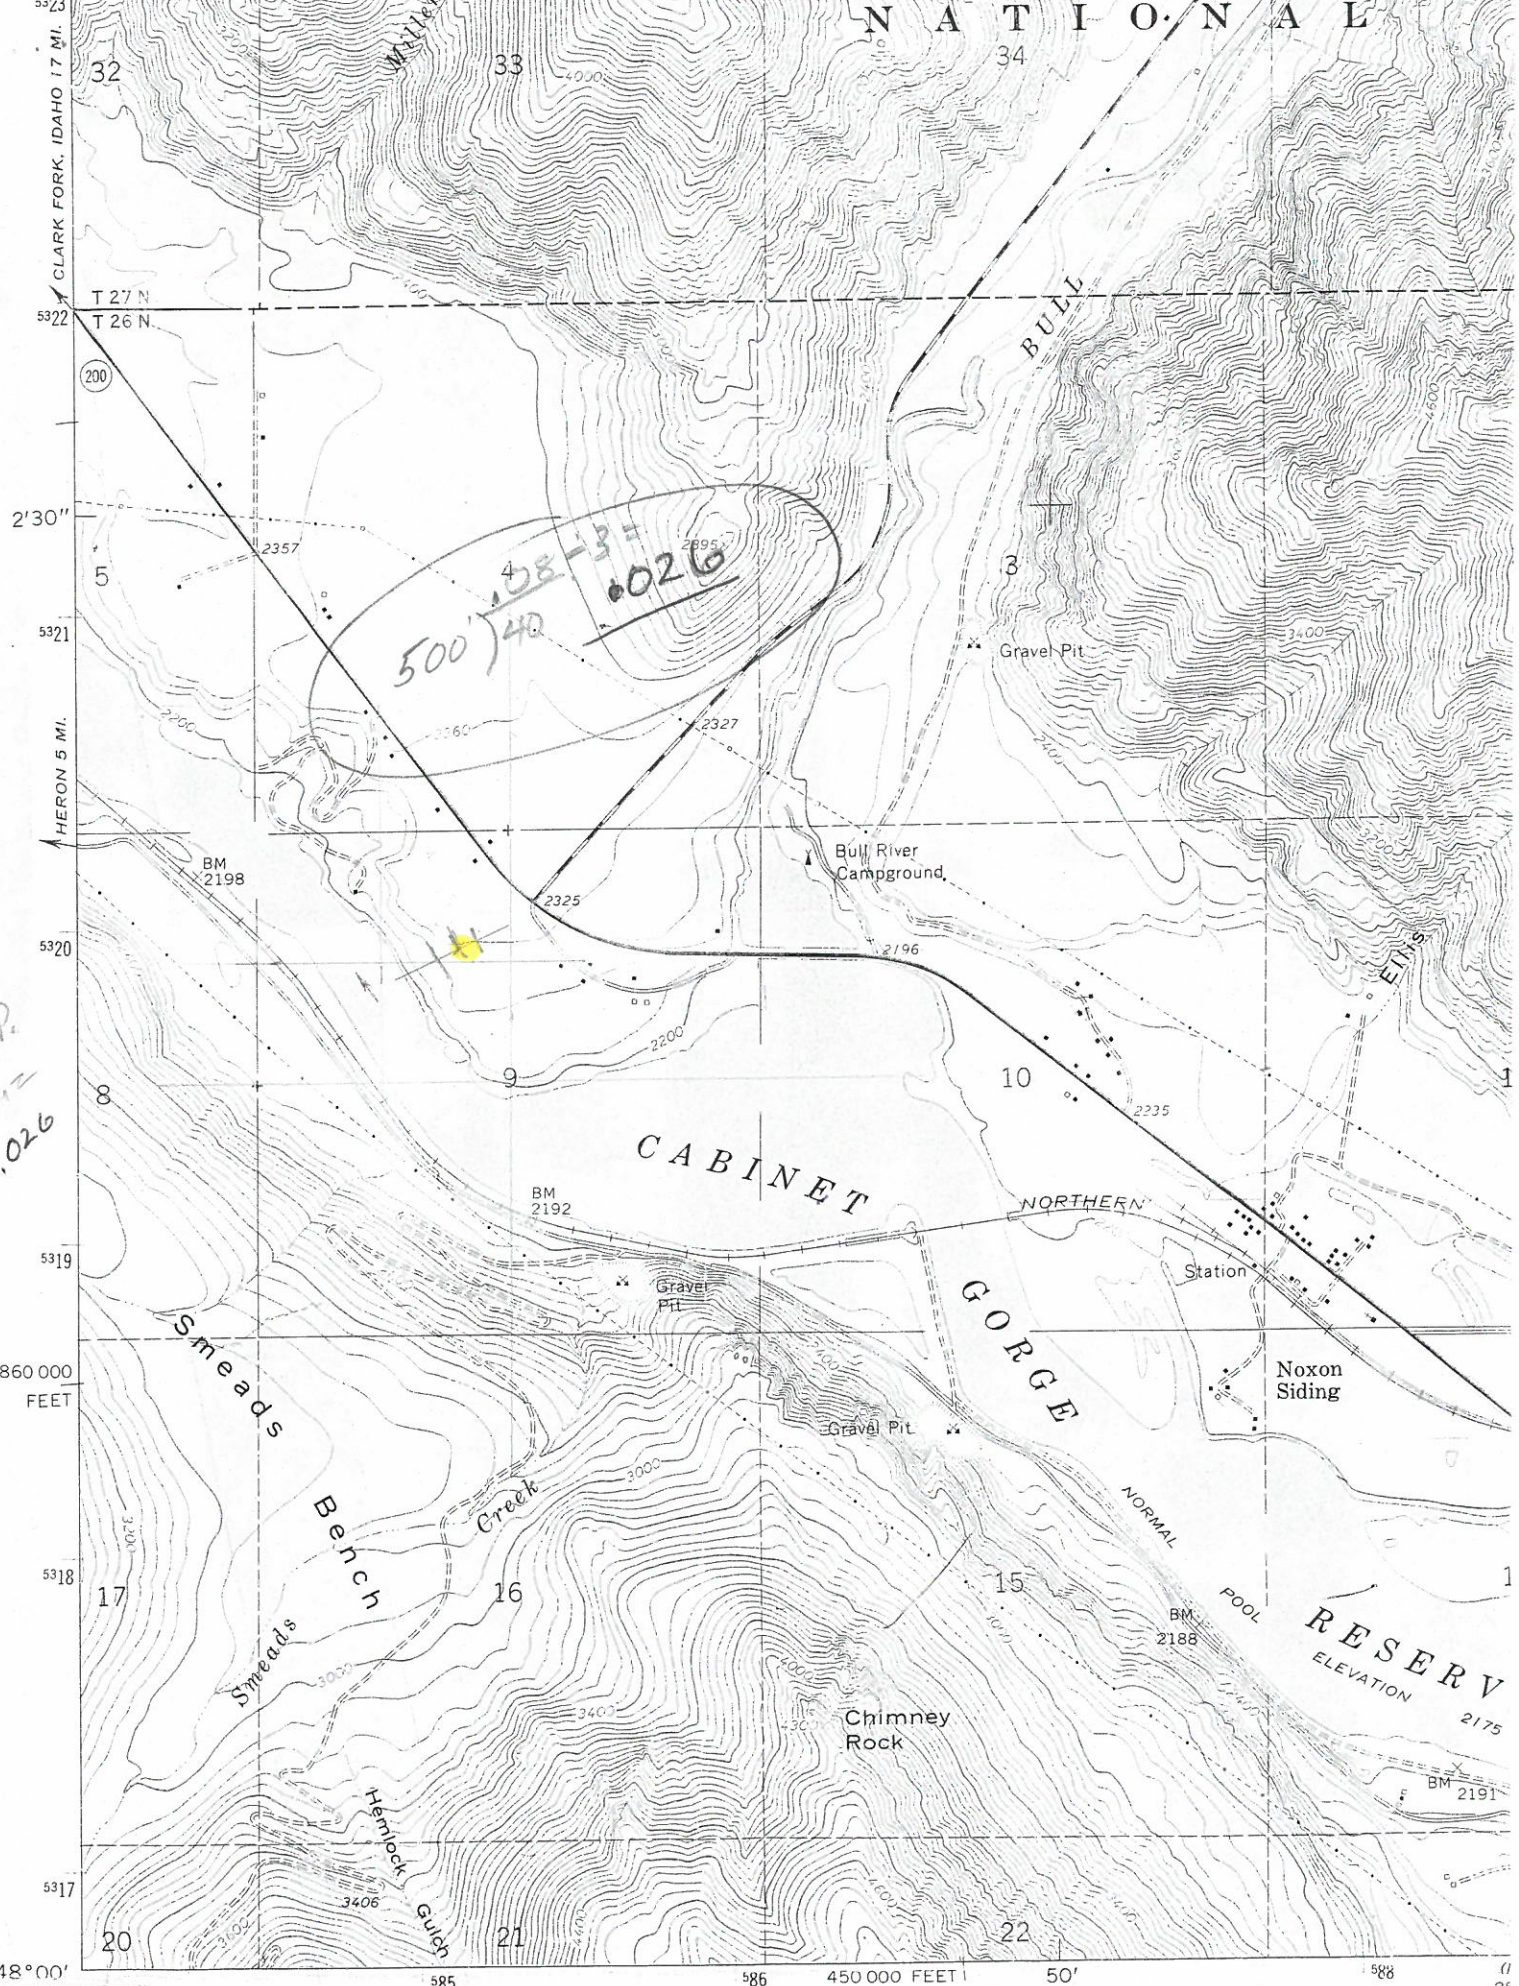

CLARK FORK, IDAHO 17 MI.

T 27 N
T 26 N

2'30"

5321

HERON 5 MI.

5320

5319

860 000
FEET

5318

5317

48°00'

115°52'30"

585

586

450 000 FEET

50'

588


11

101 R
100-112
AG. 026

500' 40
58-3
0026

PEAK
NW

Mapped, edited, and published by the Geological Survey
Control by USGS and USC&GS

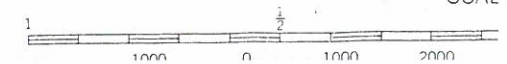

SCAL