

PERMIT APPROVAL SPECIFICATIONS
Sanders County Environmental Health Department
1111 Main St. Thompson Falls, MT, 59873 * 406.827.6961

Owner information:

Randy Hagedorn	13	22N	30W
_____	S	T	R
Name			
PO Box 2390	11/30/06		

Mailing address	Date Submitted		
Thompson Falls, MT 59873	12/05/06		

City	Date Approved		
07-119	12/05/07		

Permit Number	Expiration Date		

Permit Specifications: 4 number of bedrooms
Pressurized drainfield w/ dosing siphon per attached specifications

This permit is approved with the following specifications:

1500 septic/500 gal dose chamber
_____ gallon size of septic tank


Drainfield Design specifications:

Gravelless Chambers:

219 lineal feet

656 square feet


3 laterals @ 80 feet

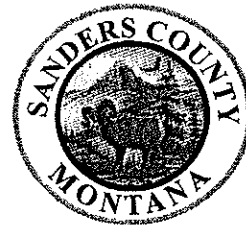

Trenches are 3 feet wide and a maximum depth of 36 inches. Please follow all county wastewater regulations & the state regulations as outlined in Circular DEQ 4 2002 edition. Install the system exactly as per approved lot layout. Pre-notification is mandatory 72 hours before backfilling system.

Barbara Woodbury R.S.

Sanders County Sanitarian

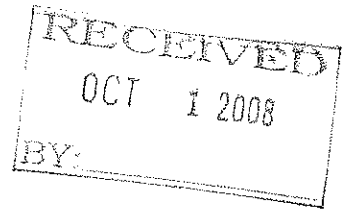

AS-BUILT SKETCH
AND
STATEMENT OF ACCURACY OF INSTALLATION

Land owner's name RANDY HAGADORN

Permit number 07-119

I, CHAD PARDEE, as the licensed installer or landowner for the following system have constructed or altered the septic system on the parcel referenced by the permit number above.

I do hereby declare that the EXACT specifications of the approved permit have been followed. Accompanying this statement is a copy of the county approved lot layout and my as-built sketch. My as-built sketch is included on another sheet of paper. I understand that it is my responsibility to submit the above within 10 days of the completion of the system.

Installer's Signature [Handwritten Signature]

Installer's License Number 51-54

Completion Date of System 6-28-07



.....
Checklist of as-built sketch:

- North Arrow
- Triangular measurements from two corners of house to tank access lid
- Measurement of pipe from tank to D-box or manifold
- All parcel boundaries
- Distance between the system and at least two parcel boundaries

Additional information needed (fill the blanks in with quantitative data):

80' length of drainfield laterals
3 number of drainfield laterals
1500 + 500 volume of septic tank
SIPHON DOME

RECEIVED
OCT 1 2008
BY:

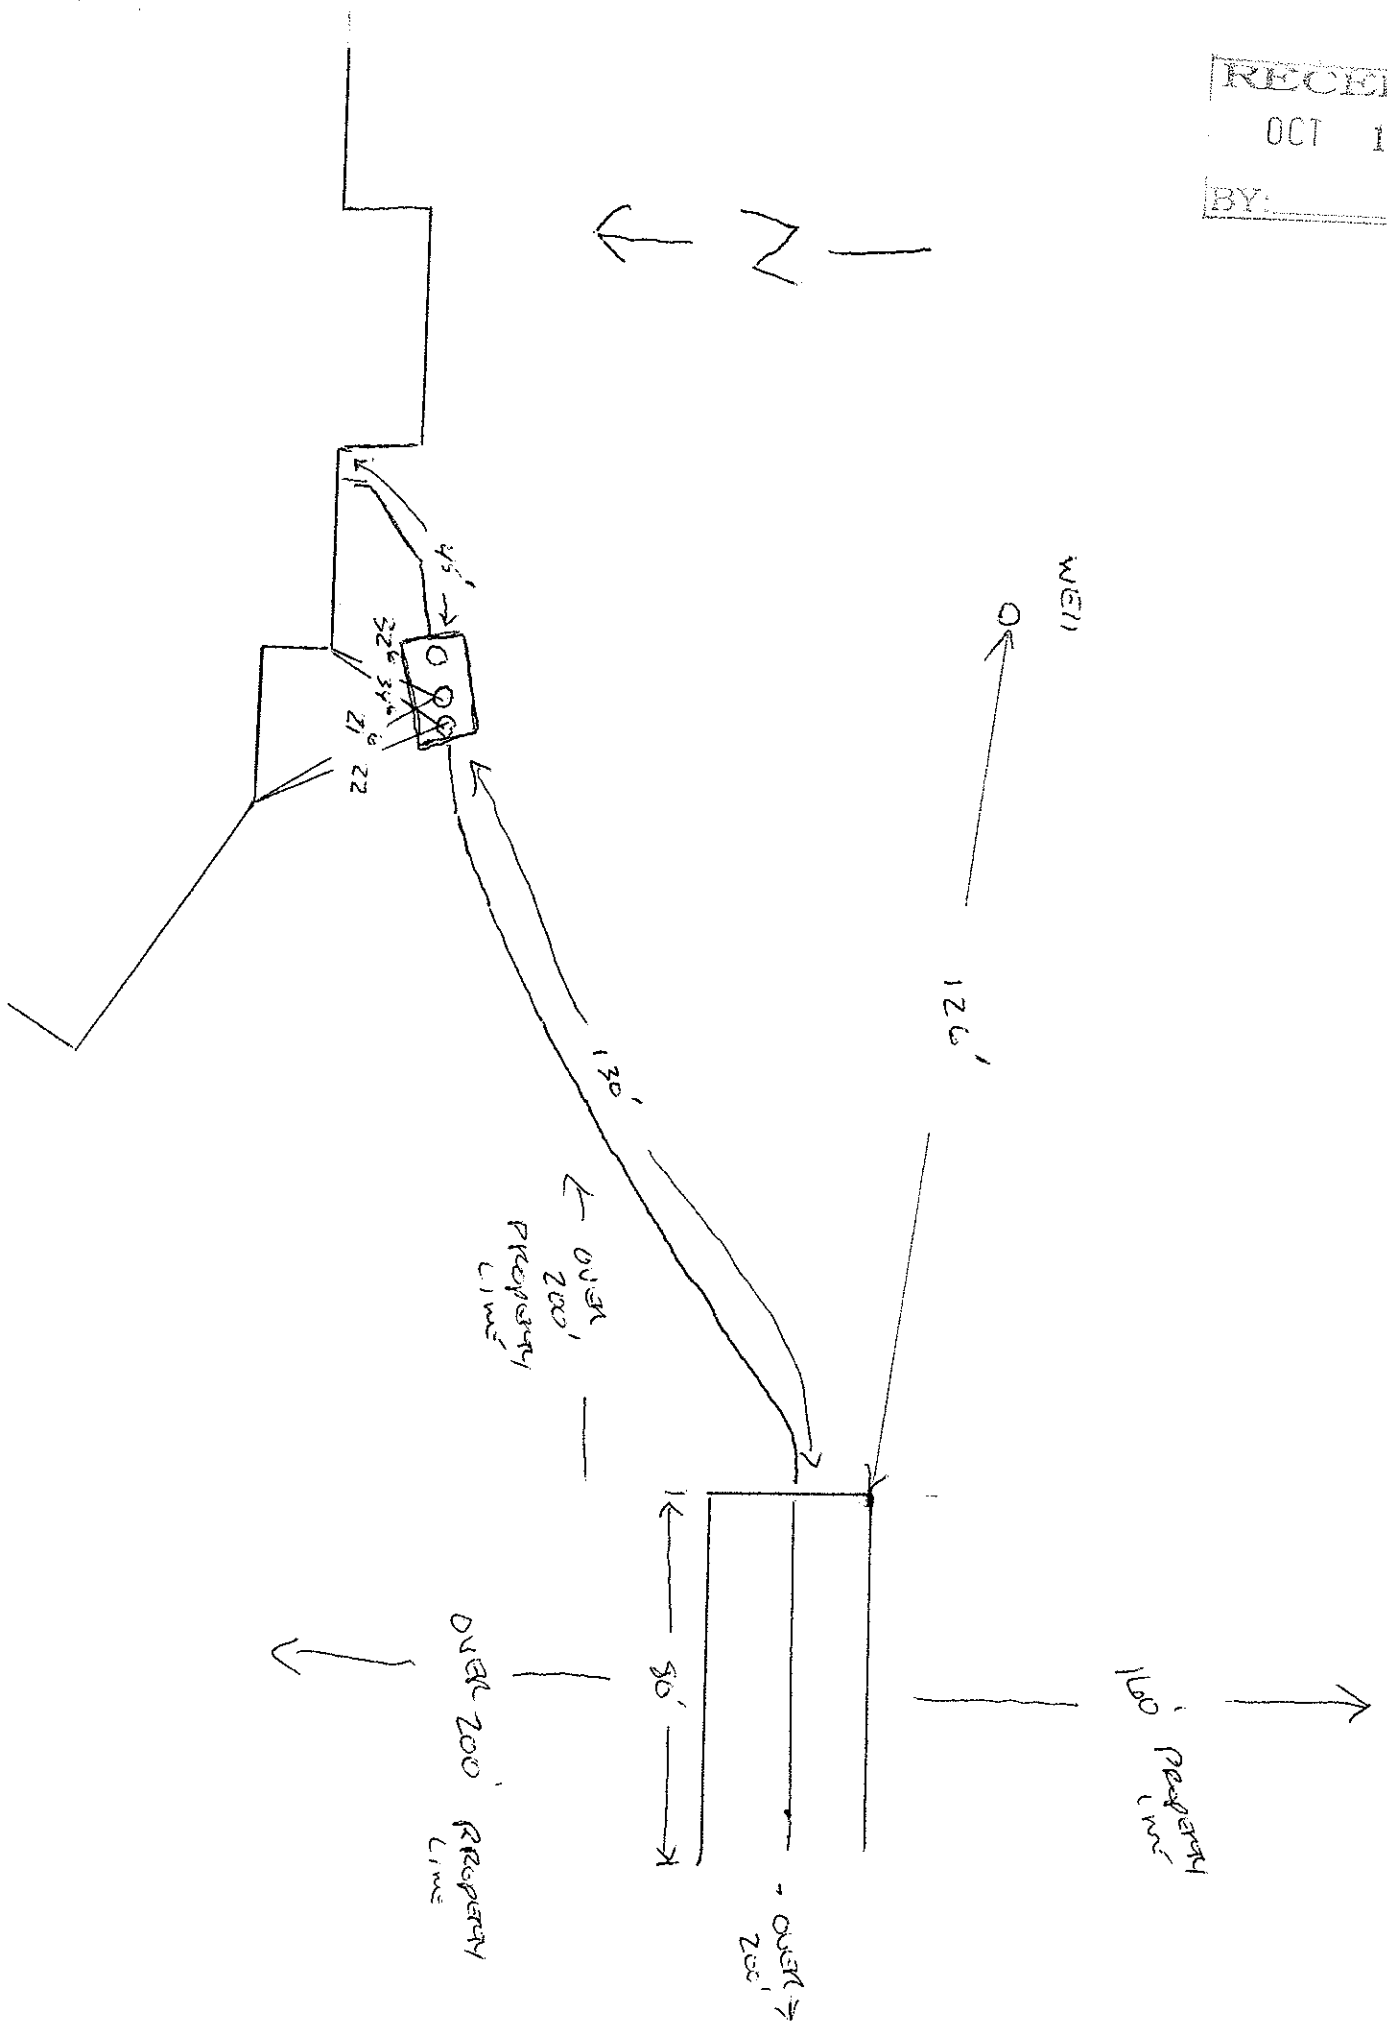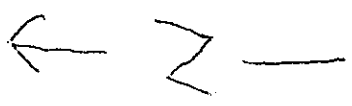

RAUDY
~~REEY~~ HALADEN
AS-BUILT