

Septic System Permit
Flathead City- County Health Department
Environmental Health Services
723 5th Ave. East, Kalispell, MT 59901

Number 02-00782-V
Site Eval Receipt 02-00541
Date Issued 6-21-02
Zone: 4
Date Recorded 2/4/2002

1. Legal Description: Co. Assess.Tr.# 2A Sec 27 Twp 28 Rng: 19

Subdiv. Name: _____ Lot: _____ Block _____
Cos 5673 Parcel Size _____ acres
Property Address 300 Strawberry Lake Road, Kalispell MT

2. Raymond Veilleux P. O. Box 10882, Kalispell MT 755-6912 or 261-0129
Legal Property Owner Address and Phone

New Replacement Alter/Repair

4. Proposed Structure Conv. Mob. Home Multi-Fam. (specify) _____
Sing. Fam. _____
Commercial (specify) _____ Other (specify) 2 1 Bedroom Cabins

5. No. of Bedrooms _____ o Occ No: _____ Existing Structure Home

6. Water Supply: Individ. Multi-user Public: _____ Source Well

7. Soil Type: Stony, loamy silt How Determined: TH 2002

8. Depth to Groundwater Table/Bedrock >84 Inches How Determined: Prev Exp

System Specifications:

9. Classification 1G Septic Tank Size: 1000 gal (min) Absorption Area 400 ft²

10. Drainfield Description

Use the approved drainfield site in the test hole area. Slope must not exceed 15%. Use a common 1000 gallon septic tank.

DRAINFIELD LATERALS MUST BE AT LEAST 80 FEET LONG.

Use 200 lineal feet of perforated pipe in 2 foot wide trenches with trench depth no deeper than 36 inches. Perforated pipe and lateral trench bottoms are to be level and no single drainfield lateral is to exceed 100 feet from solid header. EFFLUENT FILTER MUST BE INSTALLED. Plan carefully and be sure of all County septic system regulations and construction standards for sloped sites.


NOTE: Minimum well separations = 50 feet to solid lines and septic tank and 100 feet to drainfield.

4/30/2002 Dick Quist, R.S.
Date Signature Authorizing Approval of Permit

* These requirements establish the MINIMUM STANDARDS for this septic system installation. The permit will be voided and declared invalid if the system is not installed within 12 months. The issuance of this permit authorizes construction of the septic system and requires the installation comply with the FLATHEAD COUNTY REGULATIONS FOR SEWAGE TREATMENT SYSTEMS (FCRSTS). The permit will be void if the system is not utilized within three years of installation. The property owner is responsible for operating and maintaining the system in accordance with FCRSTS. Failure to comply with these regulations may result in revocation of this permit. This permit does not constitute a design and does not bind or obligate this office to guarantee the performance of the system. This permit shall be given to the installer prior to construction. The owner shall give 24 hours advance notice for the required inspection of the system. Please call 758-5760.

0969400

↑ N
NO SCALE

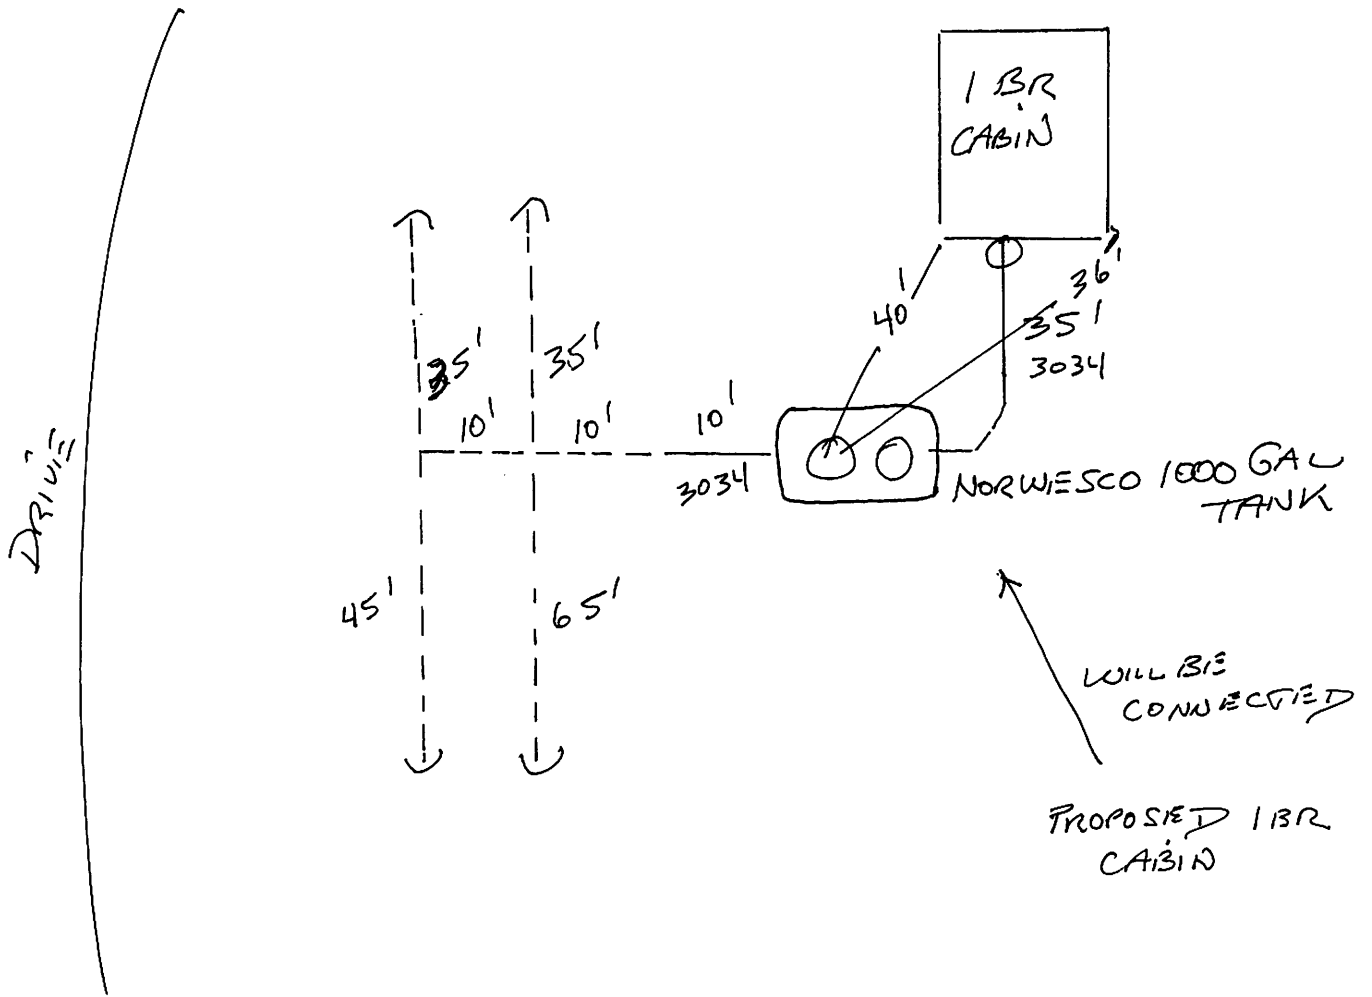

OWNER/INSTALLER WILL INSTALL FILTER.

APPROVED 6/28/03

INSTALLER
SILV