

Summit

MISSOULA CITY-COUNTY HEALTH DEPARTMENT
301 W. Alder 728-4515

19
16
21

Permit No. 83-148
Log No. _____

INDIVIDUAL SEWER SYSTEM INSPECTION REPORT

Name of Owner Kyle Hane

Name of Installer Barry Seaman

Legal Address Summit - Condon area T 19 R 16 Sec 21

Water Supply: Private _____ Public _____

Description of System: New X Replacement _____

Septic Tank Capacity 1000

Drainfield Material PVC

Septic Tank Material CONCRETE

Drainfield Length 200

Depth of Septic Tank 1 FT

Drainfield Depth 18-24"


Other _____

Soil Type (GRAVEL) SANDY LOAM

Distance of Installation from:

Property Lines: Front _____ Back _____ Side _____

Wells _____ Canals _____ Lakes _____ Streams _____

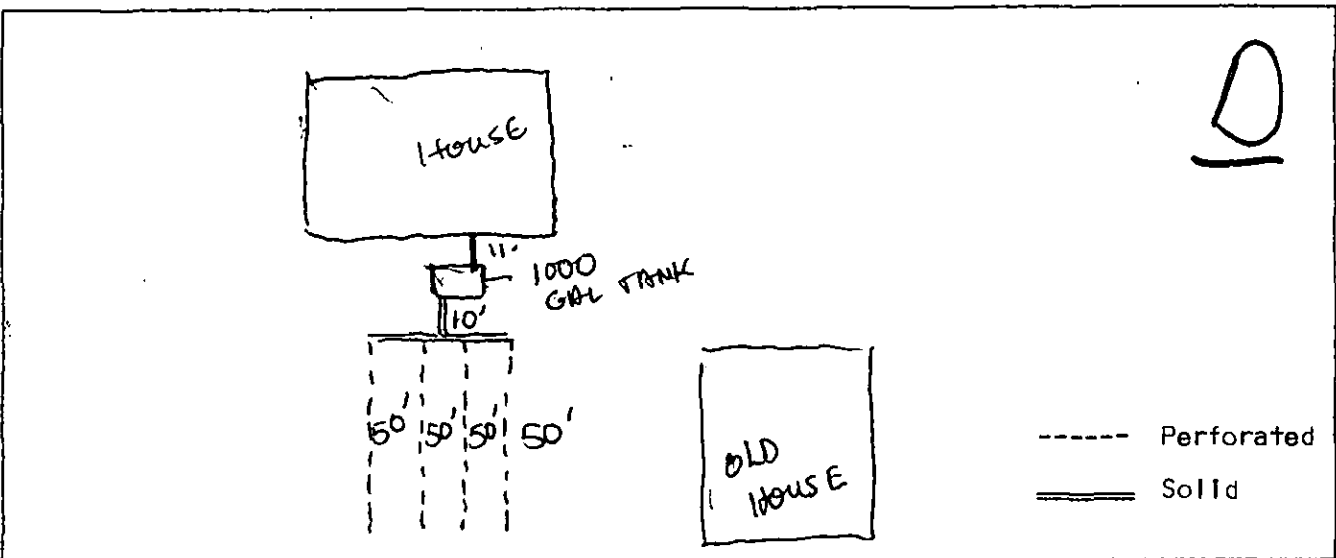

Installation Inspected:

☐ Disapproved

☒ Approved

Edward J. Fulger
Sanitarian
Sanitarian

Date
4/10/84
Date

Corrections Necessary: None

Inspection Witnessed By Barry Seaman

4/10/84
Date

APPLICATION FOR SEWER PERMIT

Name of Owner Kyle Hane Zoning Compliance Permit No. _____
Name of Installer Barry Seaman C-1
Location of Installation: (Property address, Subdivision, or Legal Description)
10 acre parcel Summit Condomes T19 R16 Sec 21

Residential: Number of Bedrooms 3 Sewage Flow, gal./day _____
Depth to Groundwater _____ Water Supply: Private X
Soil Type GRAVEL Municipal _____
Percolation Rate 5 min/inch
Type of System to be Installed: New X Replacement _____
Brief Description 1000 GAL TANK AND 200 FT OF DRAINFIELD
Special Conditions Drainfield should not be any closer than 25 ft to edge of dropoff

Applicant's Signature _____ Date _____
Plans Disapproved _____ Date _____
Plans Approved _____ Date _____

The above is not a permit. It is an approval for which a permit must be obtained within 12 months of the approval date, or the approval is no longer valid. The permit must be obtained prior to beginning of construction.

PERMIT TO INSTALL AN INDIVIDUAL SEWER SYSTEM

Permit Fee 85.00

As purchaser of this permit, I agree to install an individual sewer system which meets all requirements as specified in the Missoula County rules and regulations for subsurface sewage disposal systems.

Permit Purchaser X Kyle Hane Date _____
Health Authority David J. Guleger Date 17 May 83

This permit is valid for 12 months. Construction of the sewage disposal system must commence during this time or the permit is no longer valid. A final inspection by the Department is required prior to covering the installed system. Applicant's copy of the permit must be on-site at the time of inspection.