LAKE LOUISE

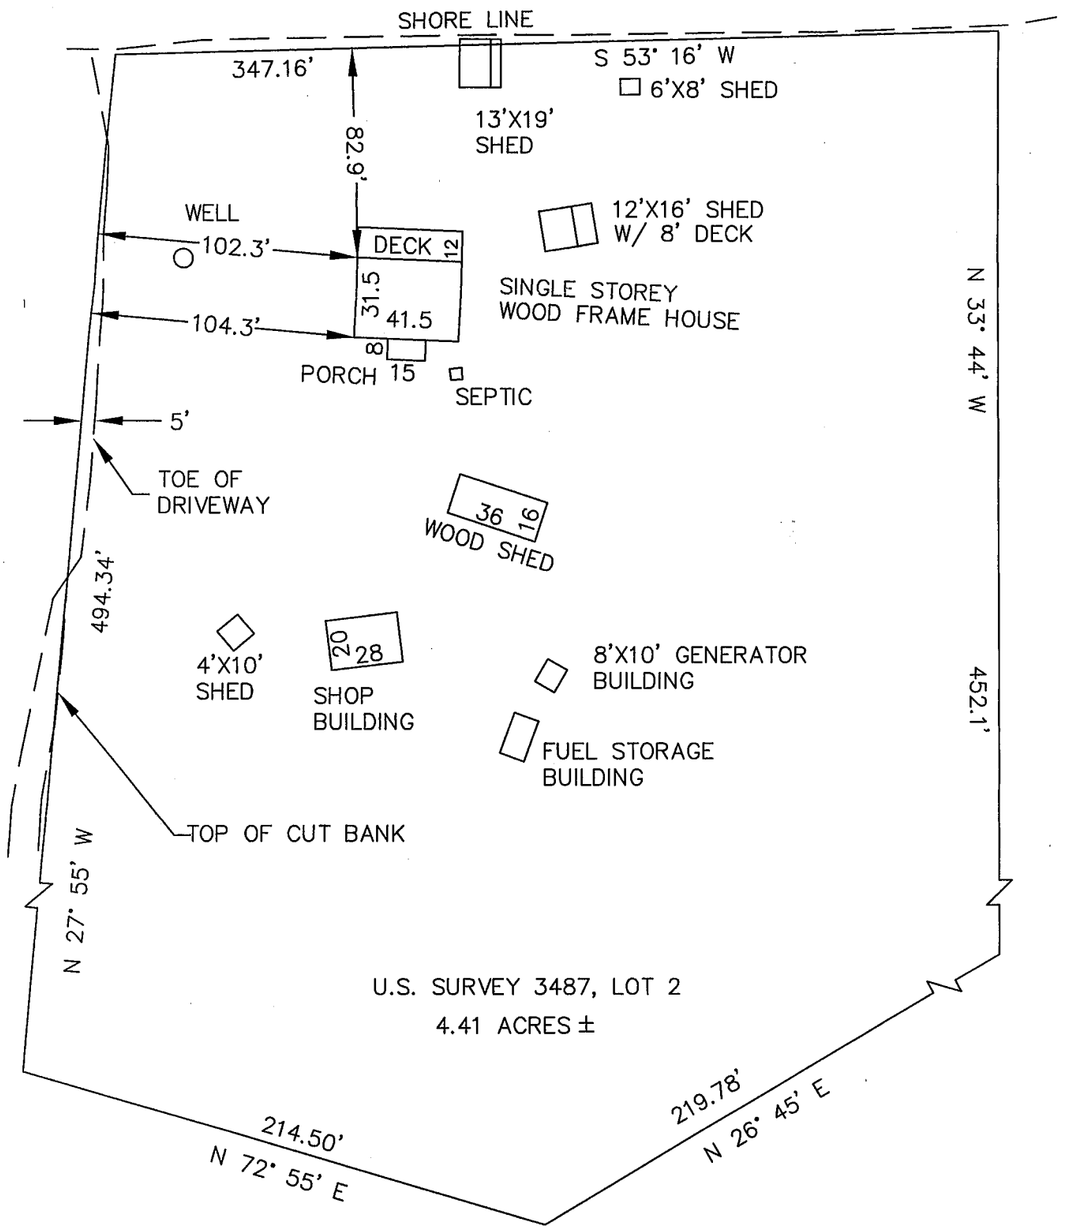

HUGHES & ASSOCIATES
SURVEYORS – ENGINEERS
2970 COTTLE LOOP WASILLA, AK (907) 373-6999

AS-BUILT

I hereby certify that the improvements situated on ---------- --- are within the property lines and do not encroach on the property lying adjacent thereto; that no improvements on property lying adjacent thereto encroach on the premises in question and that there are no roadways, transmission lines or other visible easements on said property except as indicated hereon.

It is the responsibility of the owner or builder, prior to construction, to verify property lines and proposed building grade relative to finish grade and utility connections and to determine the existence of any easements, covenants or restrictions which do not appear on the recorded subdivision plat.

STATE OF ALASKA 49TH
JACK S. HUGHES
LS-4915
REGISTERED PROFESSIONAL LAND SURVEYOR

Scale: 1" = ??'	Date:	Drawn by: JSH	Drwn No.: